


I CERTIFY THAT THIS PLAN SHOWS THE UNIT DESIGNATION OF THE UNITS BEING CONVEYED AND OF IMMEDIATELY ADJOINING UNITS, AND THAT IT FULLY AND ACCURATELY DEPICTS THE LAYOUT OF THE UNIT, ITS LOCATION, DIMENSIONS, APPROXIMATE AREA, MAIN ENTRANCE AND IMMEDIATE COMMON AREA TO WHICH IT HAS ACCESS.


Joseph D. LaGrasse AIA
REGISTERED ARCHITECT

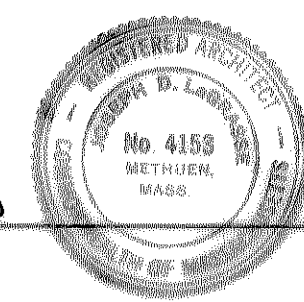

3 June 86
DATE

I CERTIFY THAT I HAVE CONFORMED TO THE RULES AND REGULATIONS OF THE REGISTRY OF DEEDS IN PREPARING THIS PLAN.


Joseph D. LaGrasse AIA
REGISTERED ARCHITECT

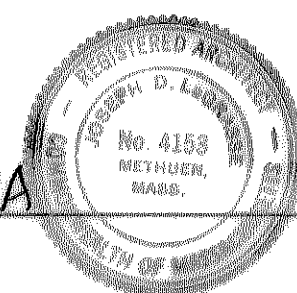


3 June 86
DATE

I HEREBY CERTIFY THAT THIS PLAN FULLY AND ACCURATELY DEPICTS THE LAYOUT, LOCATION, UNIT NUMBER AND DIMENSIONS 'AS-BUILT' FOR UNITS 31-36 AT CHESTNUT GREEN CONDOMINIUM AT DANVERS; DANVERS, MASS.

Joseph D. LaGrasse AIA
REGISTERED ARCHITECT

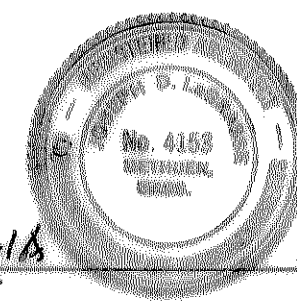


3 June 86
DATE

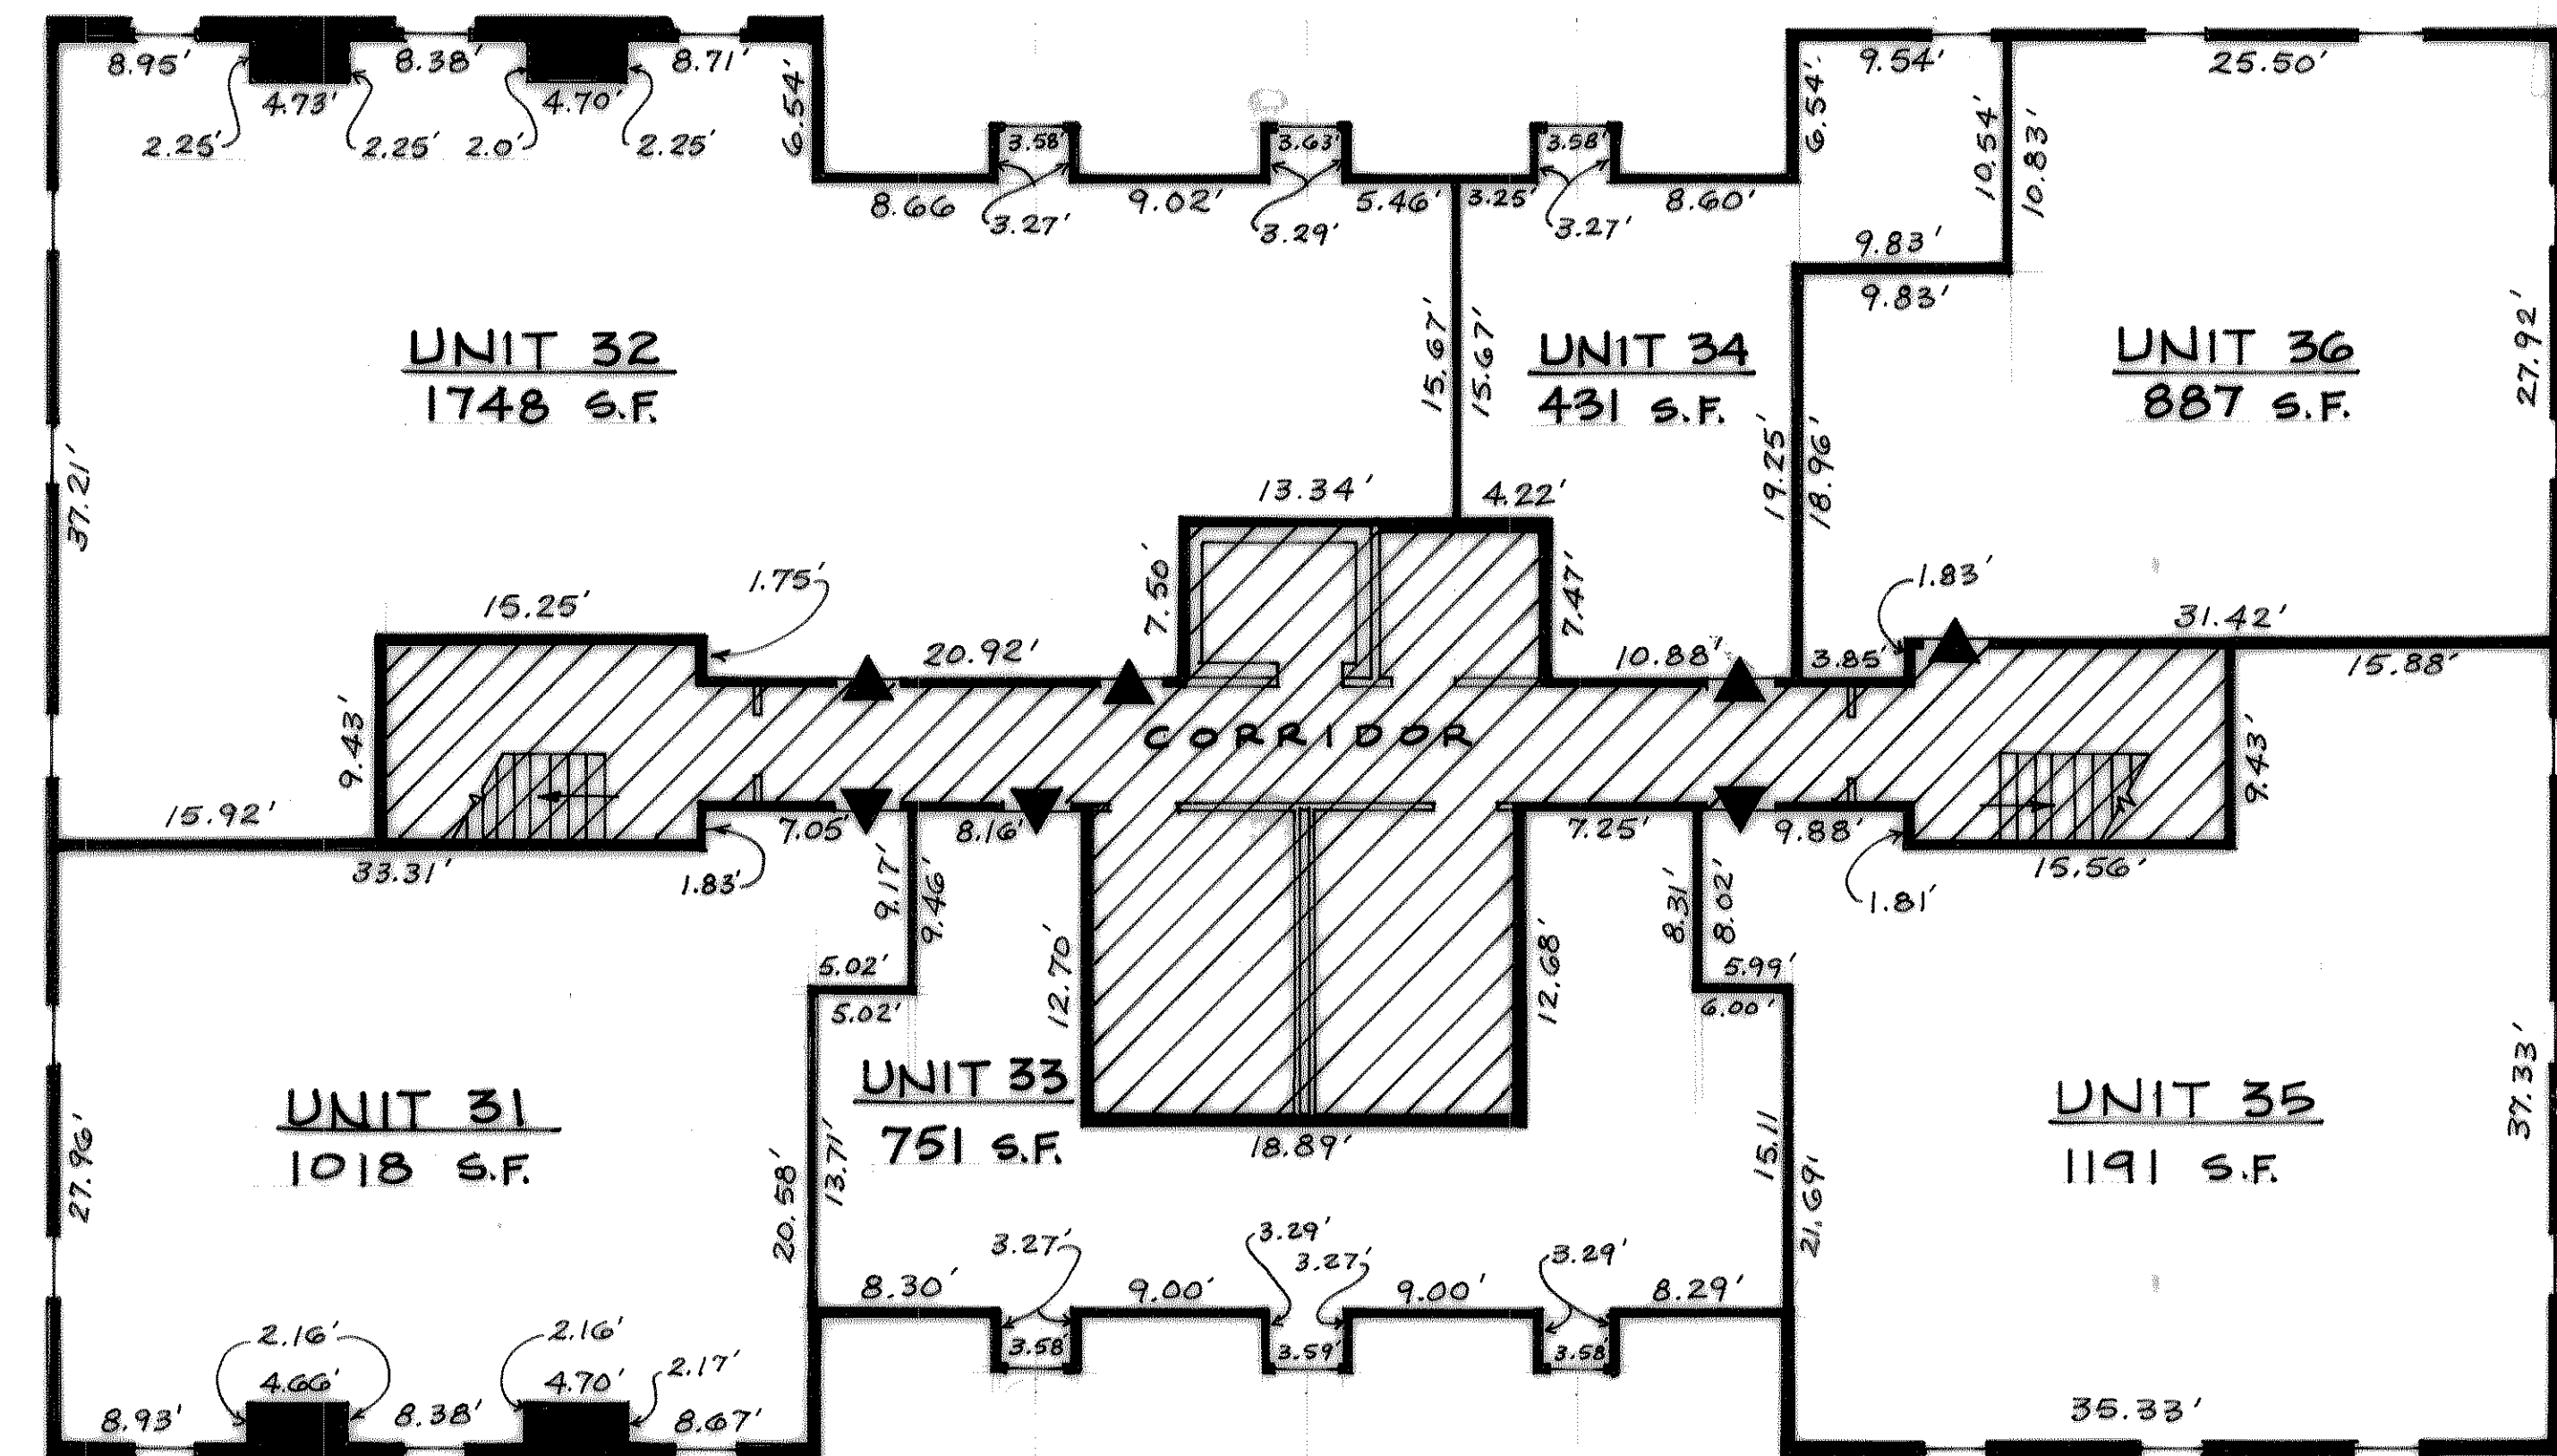

LEGEND

COMMON AREA
WINDOW (COMMON AREA)
DEMISING WALL (COMMON AREA)
(DIMENSIONED FROM FACE OF STUD TO FACE OF STUD)
UNIT ENTRANCE

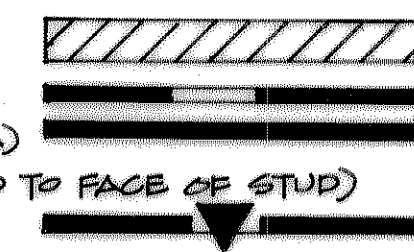

	UNIT	AREA	% INTEREST
FIRST FLOOR	11	972	5.49
	12	888	5.01
	14	2101	11.86
	15	447	2.53
	17	565	3.19
	19	822	4.64
SECOND FLOOR	21	1352	7.64
	22	870	4.91
	23	495	2.80
	24	991	5.60
	25	976	5.51
	26	1203	6.79
THIRD FLOOR	31	1018	5.75
	32	1748	9.87
	33	751	4.24
	34	431	2.43
	35	1191	6.73
	36	887	5.01
NET AREA		17,708	
	COMMON AREA	4430	
TOTAL GROSS AREA		22,138 SF	100.00%

FOR REGISTRY USE

THIRD FLOOR OF CHESTNUT GREEN CONDOMINIUM AT DANVERS 7 FEDERAL STREET IN DANVERS, MASS.

SCALE: 1/8" = 1'-0" 3 JUNE, 1986

JOSEPH D. LAGRASSE & ASSOCIATES, INC.
ARCHITECTS • ENGINEERS • LAND PLANNERS
ONE ELM SQUARE
ANDOVER, MASS.



I CERTIFY THAT THIS PLAN SHOWS THE UNIT DESIGNATION OF THE UNITS BEING CONVEYED AND OF IMMEDIATELY ADJOINING UNITS, AND THAT IT FULLY AND ACCURATELY DEPICTS THE LAYOUT OF THE UNIT, ITS LOCATION, DIMENSIONS, APPROXIMATE AREA, MAIN ENTRANCE AND IMMEDIATE COMMON AREA TO WHICH IT HAS ACCESS.


I HEREBY CERTIFY THAT THIS PLAN FULLY AND ACCURATELY DEPICTS THE LAYOUT, LOCATION, UNIT NUMBER AND DIMENSIONS "AS-BUILT" FOR UNITS 11-17 & 19 AT CHESTNUT GREEN CONDOMINIUM AT DANVERS, DANVERS, MASS.

Joseph D. LaGrasse AIA
REGISTERED ARCHITECT
3 June 86
DATE

Joseph D. LaGrasse AIA
REGISTERED ARCHITECT
3 June 86
DATE

I CERTIFY THAT I HAVE CONFORMED TO THE RULES AND REGULATIONS OF THE REGISTRY OF DEEDS IN PREPARING THIS PLAN.

Joseph D. LaGrasse AIA
REGISTERED ARCHITECT
3 June 86
DATE

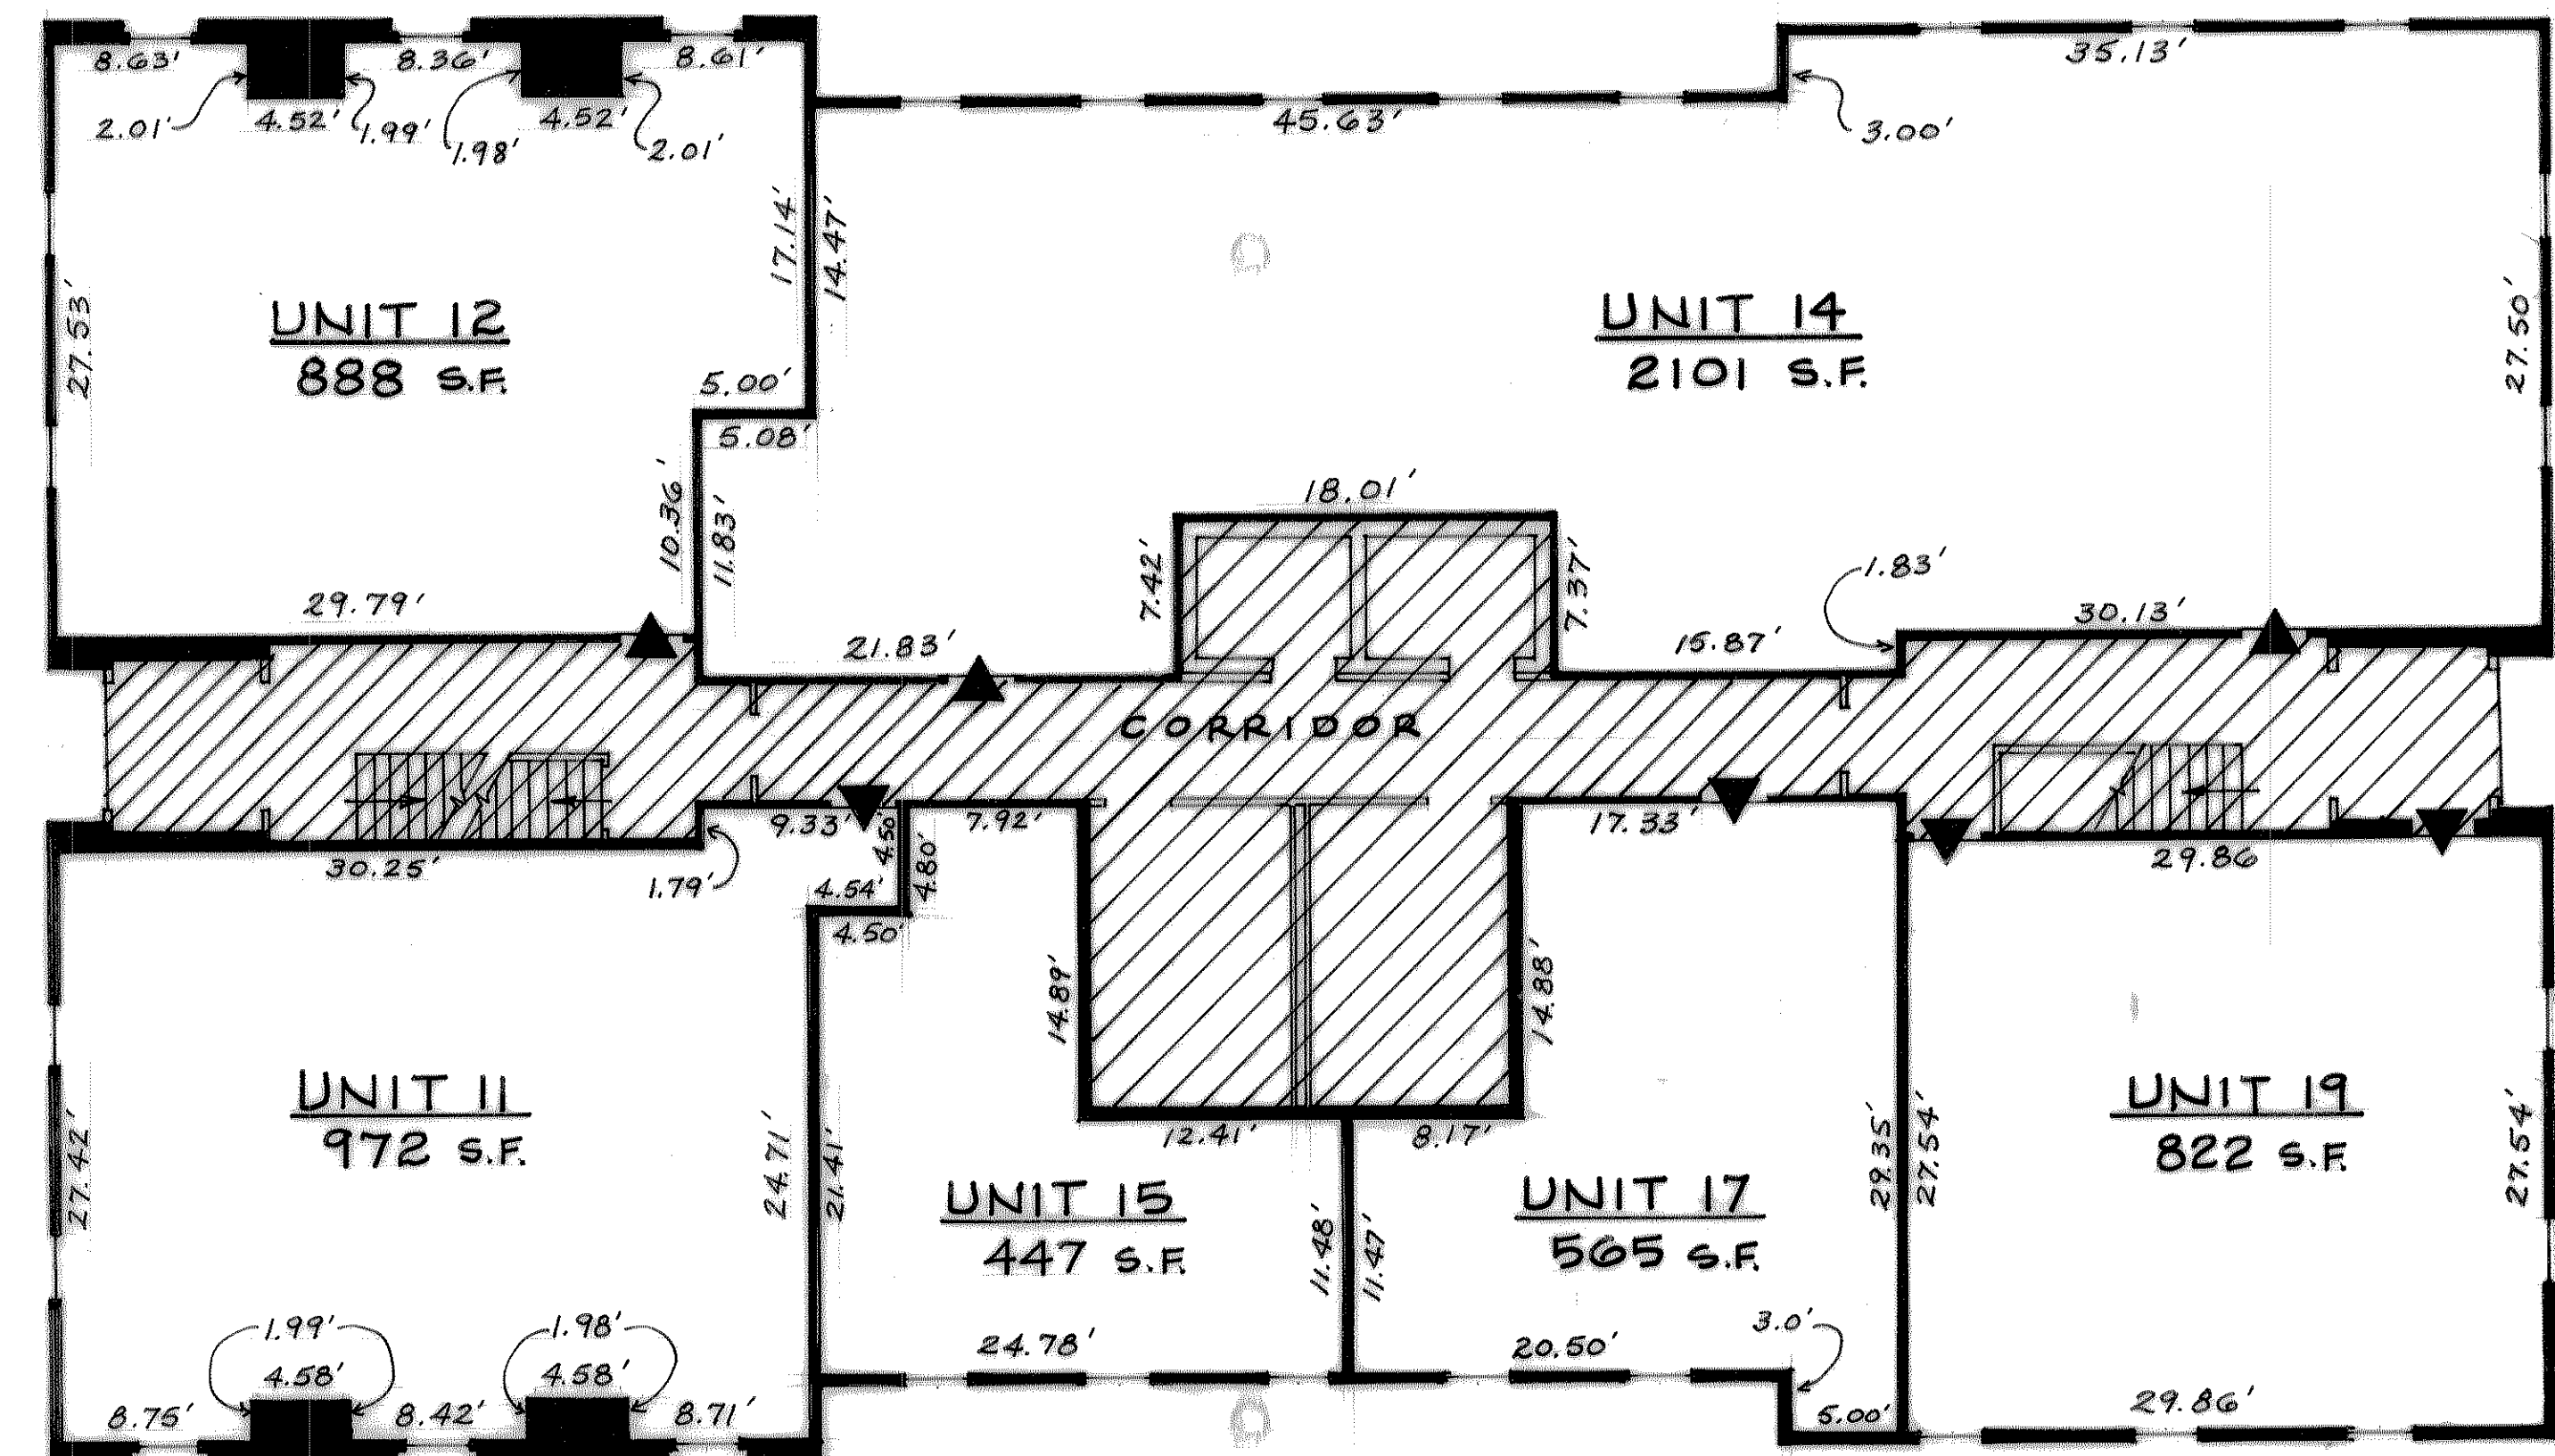


LEGEND

COMMON AREA
WINDOW (COMMON AREA)
DEMISING WALL (COMMON AREA)
(DIMENSIONED FROM FACE OF STUD TO FACE OF STUD)
UNIT ENTRANCE

	UNIT	AREA	%INTEREST
FIRST FLOOR	11	972	5.49
	12	888	5.01
	14	2101	11.86
	15	447	2.53
	17	565	3.19
	19	822	4.64
SECOND FLOOR	21	1352	7.64
	22	870	4.91
	23	495	2.80
	24	991	5.60
	25	976	5.51
	26	1203	6.79
THIRD FLOOR	31	1018	5.75
	32	1748	9.87
	33	751	4.24
	34	431	2.43
	35	1191	6.73
	36	887	5.01
NET AREA		17,708	
COMMON AREA		4430	
TOTAL GROSS AREA		22,138 S.F.	100.00%

FOR REGISTRY USE

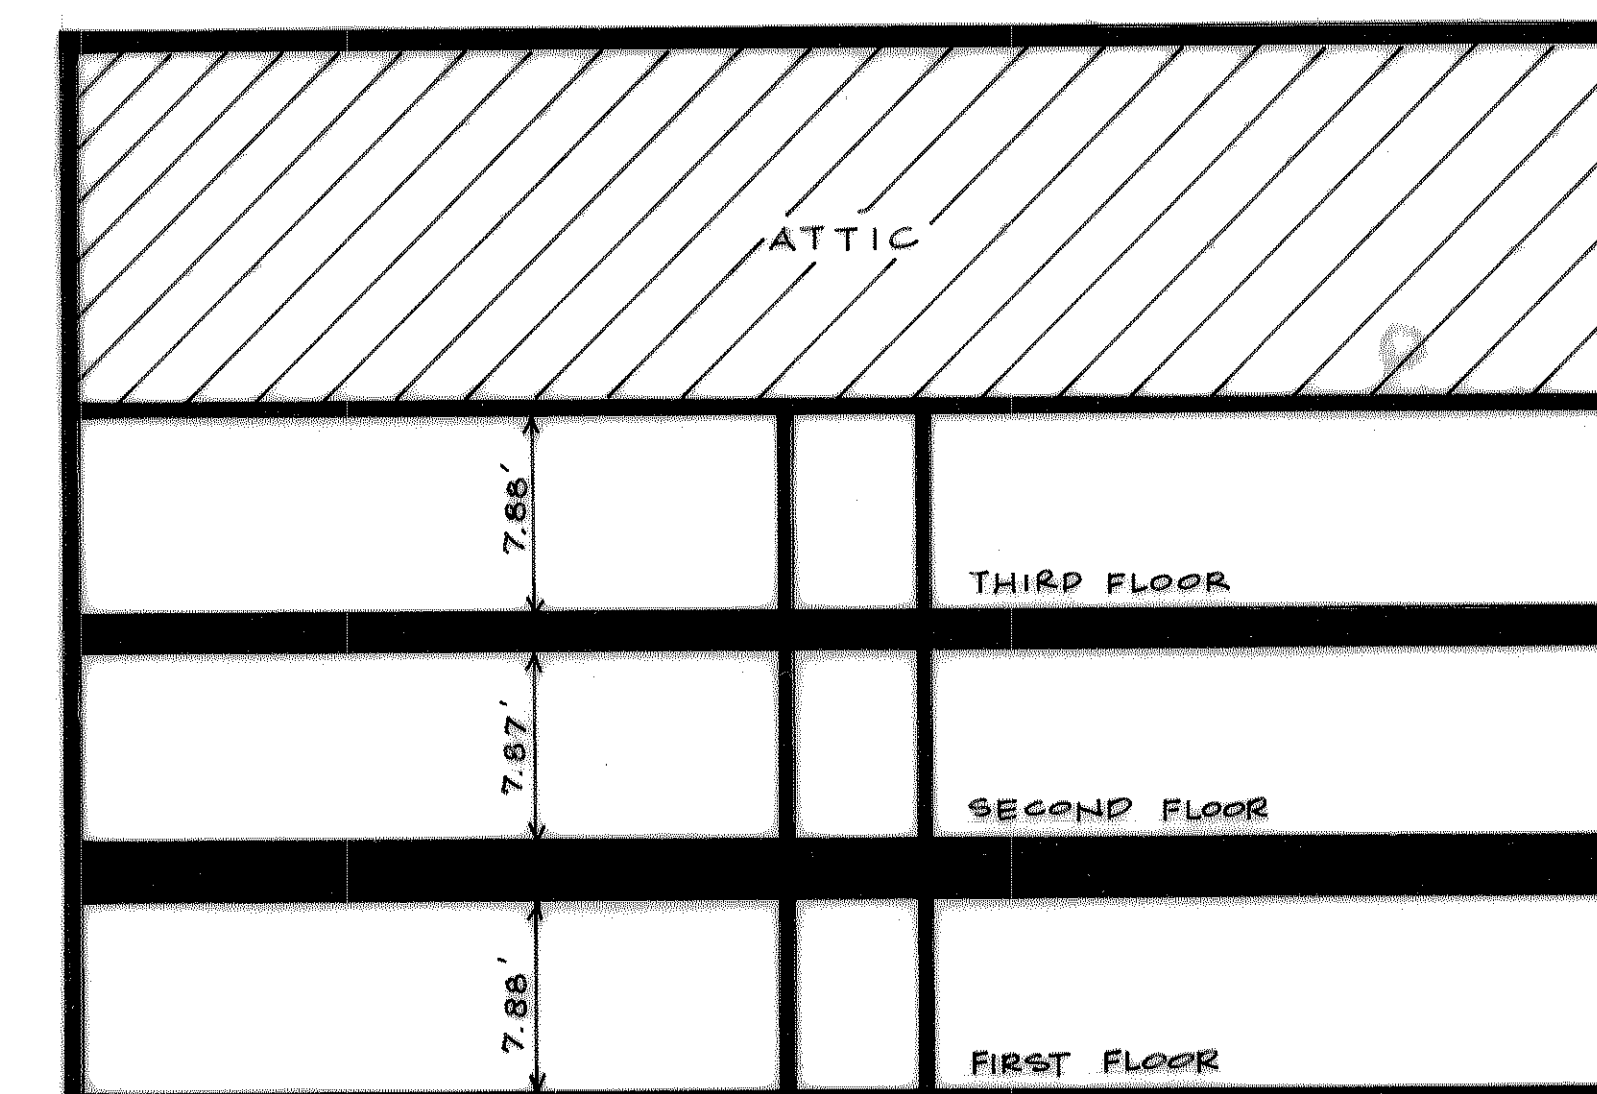

BUILDING SECTION
SCALE: 1/8" = 1'-0"

FIRST FLOOR
OF
CHESTNUT GREEN
CONDOMINIUM
AT DANVERS
7 FEDERAL STREET
IN
DANVERS, MASS.


SCALE: 1/8" = 1'-0" 3 JUNE, 1986

JOSEPH D. LAGRASSE & ASSOCIATES, INC.
ARCHITECTS · ENGINEERS · LAND PLANNERS
ONE ELM SQUARE
DANVERS, MASS.



I CERTIFY THAT THIS PLAN SHOWS THE UNIT DESIGNATION OF THE UNITS BEING CONVEYED AND OF IMMEDIATELY ADJOINING UNITS, AND THAT IT FULLY AND ACCURATELY DEPICTS THE LAYOUT OF THE UNIT, ITS LOCATION, DIMENSIONS, APPROXIMATE AREA, MAIN ENTRANCE, AND IMMEDIATE COMMON AREA TO WHICH IT HAS ACCESS.


Joseph D. LaGrasse AIA
REGISTERED ARCHITECT

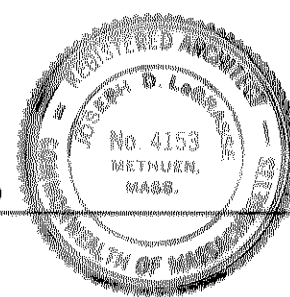

3 June 86
DATE

I CERTIFY THAT I HAVE CONFORMED TO THE RULES AND REGULATIONS OF THE REGISTRY OF DEEDS IN PREPARING THIS PLAN.


Joseph D. LaGrasse AIA
REGISTERED ARCHITECT

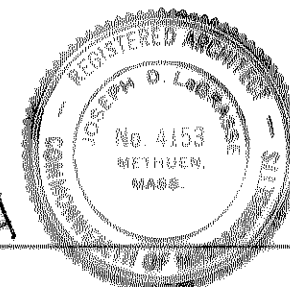


3 June 86
DATE

I HEREBY CERTIFY THAT THIS PLAN FULLY AND ACCURATELY DEPICTS THE LAYOUT, LOCATION, UNIT NUMBER AND DIMENSIONS "AS-BUILT" FOR UNITS 21-26 AT CHESTNUT GREEN CONDOMINIUM AT DANVERS; DANVERS, MASS.

Joseph D. LaGrasse AIA
REGISTERED ARCHITECT

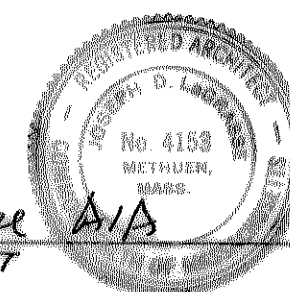


3 June 86
DATE

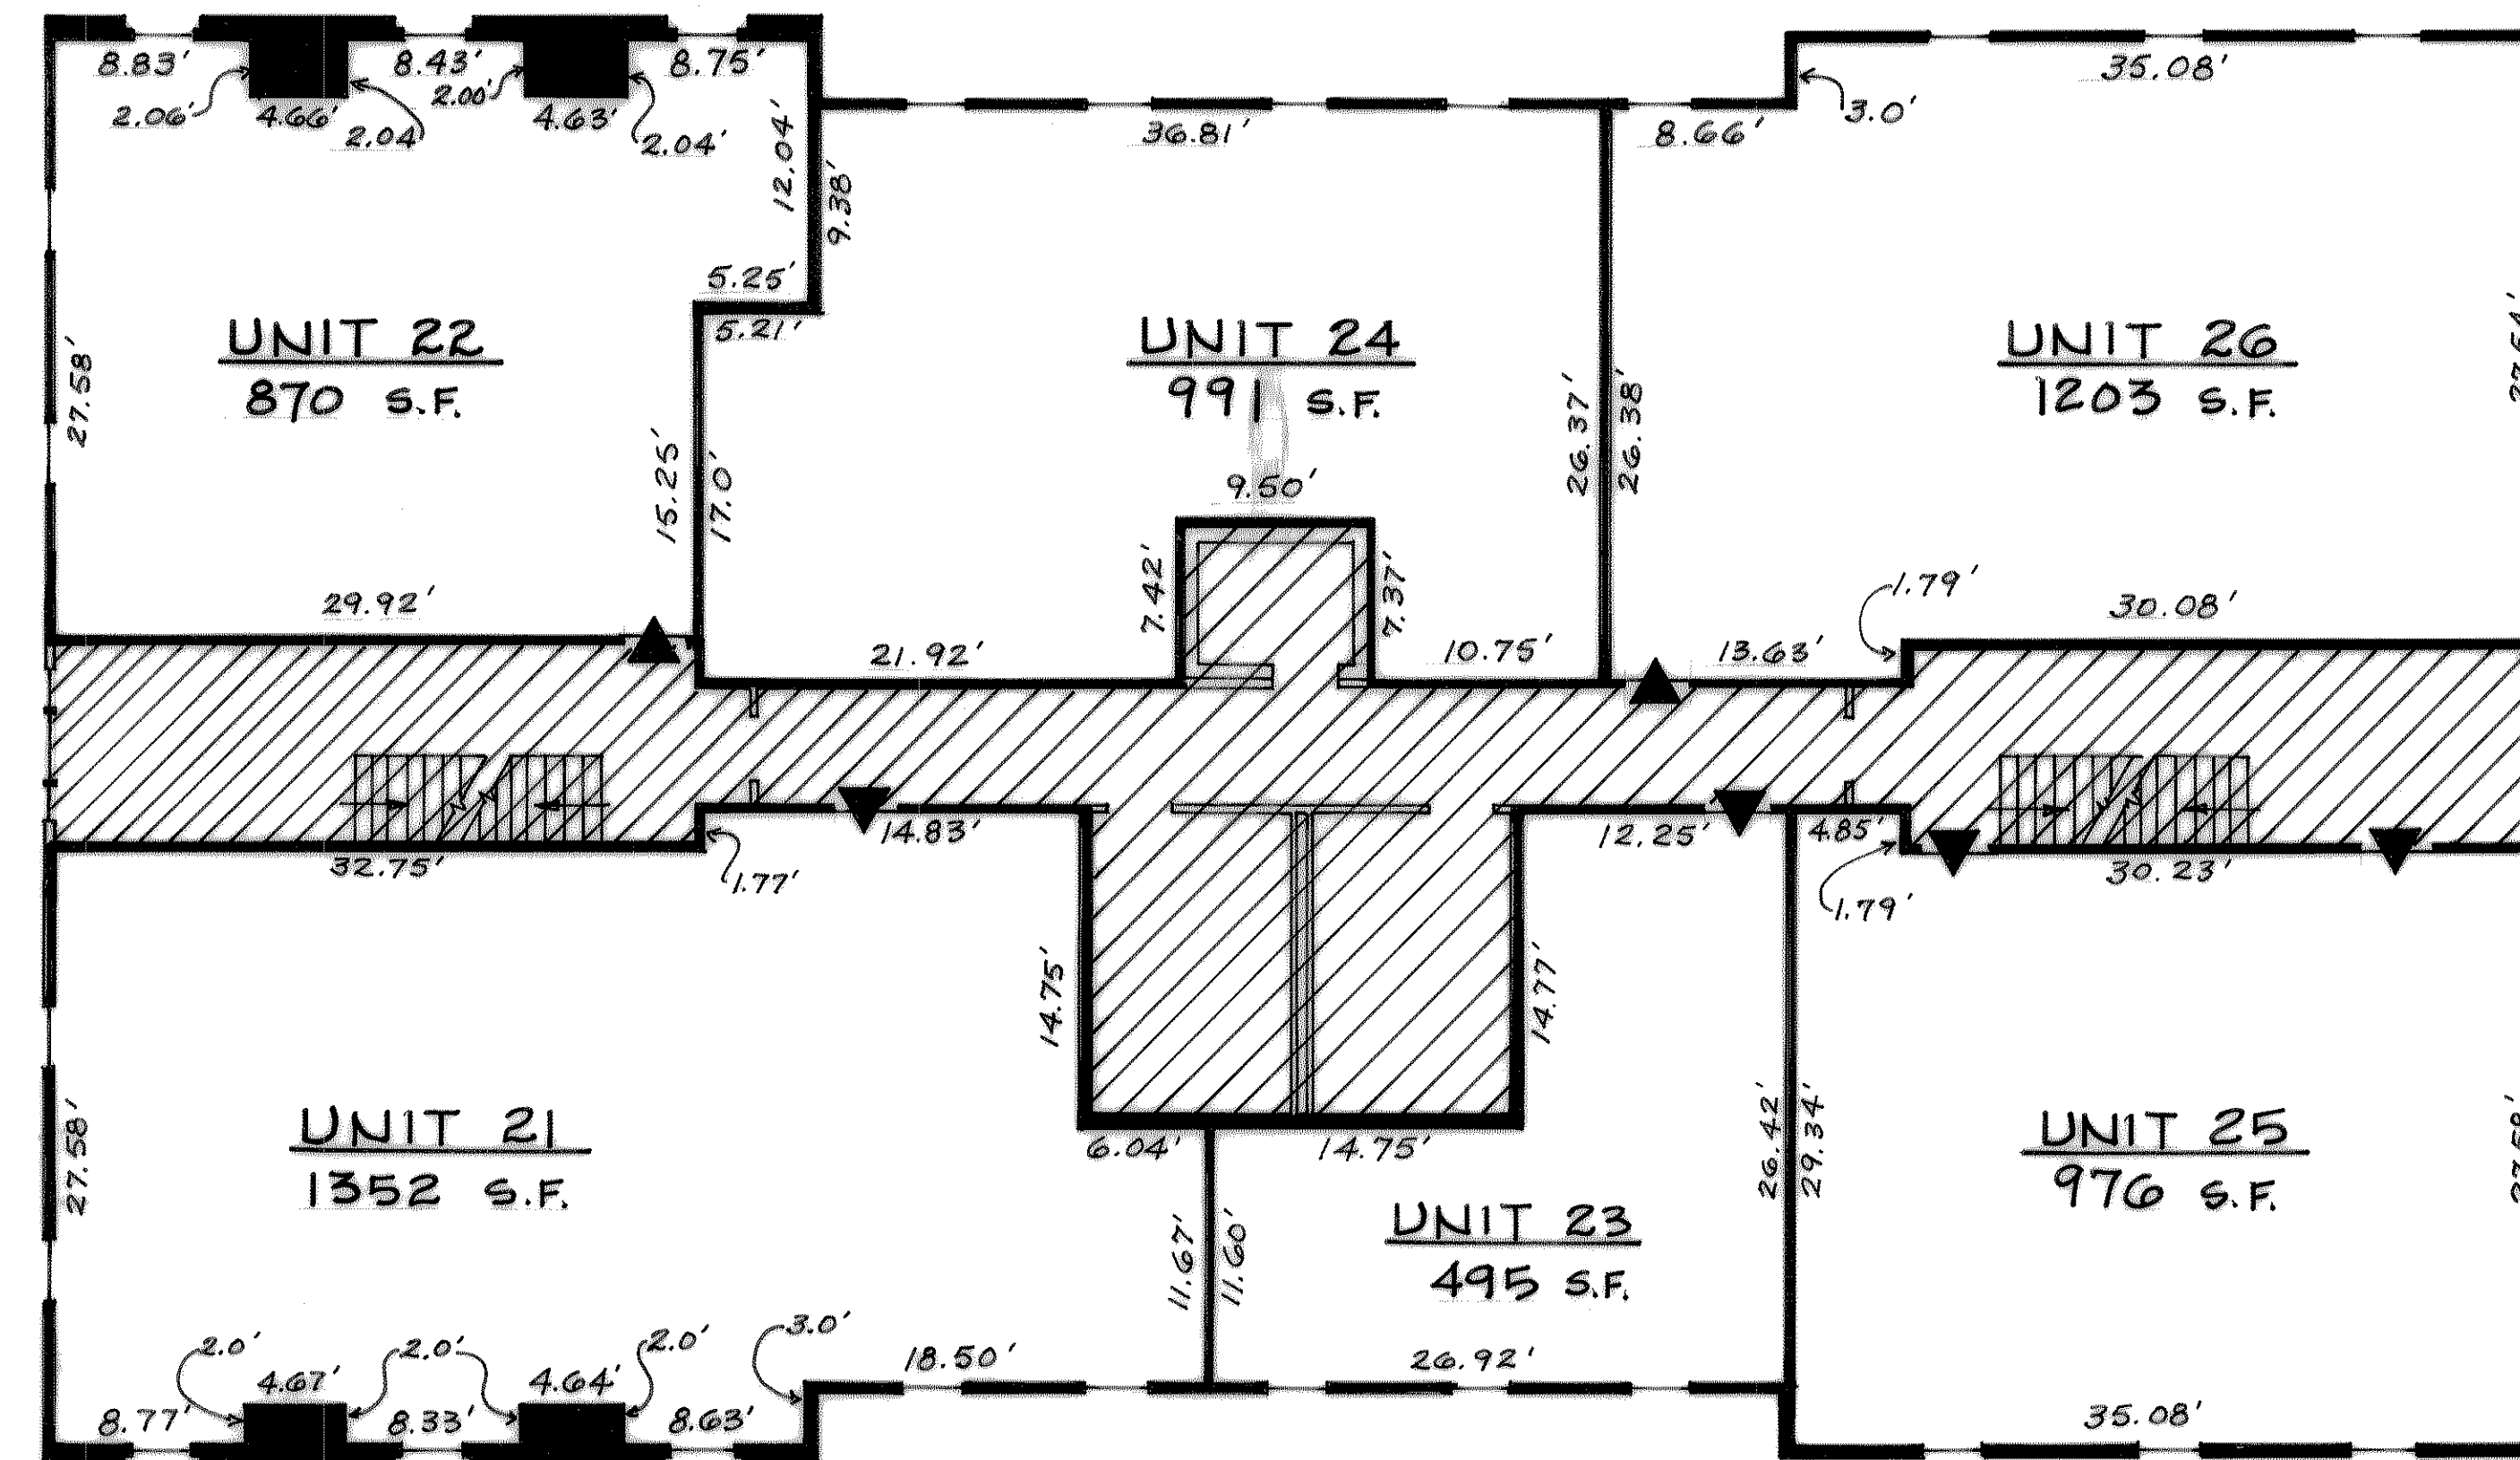

LEGEND

COMMON AREA
WINDOW (COMMON AREA)
DEMISING WALL (COMMON AREA)
(DIMENSIONED FROM FACE OF STUD TO FACE OF STUD)
UNIT ENTRANCE

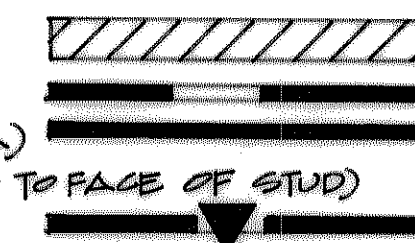

	UNIT	AREA	% INTEREST
FIRST FLOOR	11	972	5.49
	12	888	5.01
	14	2101	11.86
	15	447	2.53
	17	565	3.19
	19	822	4.64
SECOND FLOOR	21	1352	7.64
	22	870	4.91
	23	495	2.80
	24	991	5.60
	25	976	5.51
	26	1203	6.79
THIRD FLOOR	31	1018	5.75
	32	1748	9.87
	33	751	4.24
	34	431	2.43
	35	1191	6.73
	36	887	5.01
NET AREA		17,708	
COMMON AREA		4,430	
TOTAL GROSS AREA		22,138 S.F.	100.00%

FOR REGISTRY USE


SECOND FLOOR OF CHESTNUT GREEN CONDOMINIUM AT DANVERS 7 FEDERAL STREET IN DANVERS, MASS.

SCALE: 1/8" = 1'-0" 3 JUNE, 1986

JOSEPH D. LAGRASSE & ASSOCIATES, INC.
ARCHITECTS-ENGINEERS-LAND PLANNERS
ONE ELM SQUARE
ANDOVER, MASS.



I CERTIFY THAT I HAVE CONFORMED TO THE RULES
AND REGULATIONS OF THE REGISTRY OF DEEDS
IN PREPARING THIS DOCUMENT.

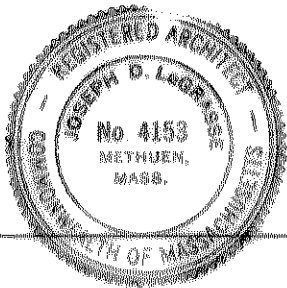

Joseph D. LaGrasse AIA
REGISTERED ARCHITECT

12 June 86
DATE

REVISED
TABULATION SHEET
FOR
CHESTNUT GREEN
CONDOMINIUM
AT DANVERS
7 FEDERAL STREET
DANVERS, MASS.

12 JUNE 1986

JOSEPH D. LAGRASSE & ASSOCIATES, INC.
ARCHITECTS • ENGINEERS • LAND PLANNERS
ONE ELM SQUARE
ANDOVER, MASS.

	UNIT	AREA	% INTEREST
FIRST FLOOR	11	972	5.49
	12	888	5.01
	14	2101	11.86
	15	447	2.53
	17	565	3.19
	19	822	4.64
SECOND FLOOR	21	1352	7.64
	22	870	4.91
	23	495	2.80
	24	991	5.60
	25	976	5.51
	26	1203	6.79
THIRD FLOOR	31	1018	5.75
	32	1748	9.87
	33	751	4.24
	34	431	2.43
	35	1191	6.73
	36	887	5.01
NET AREA		17,708	
COMMON AREA		4668	
TOTAL GROSS AREA		22,376 SF	100.00%

FOR REGISTRY USE

